
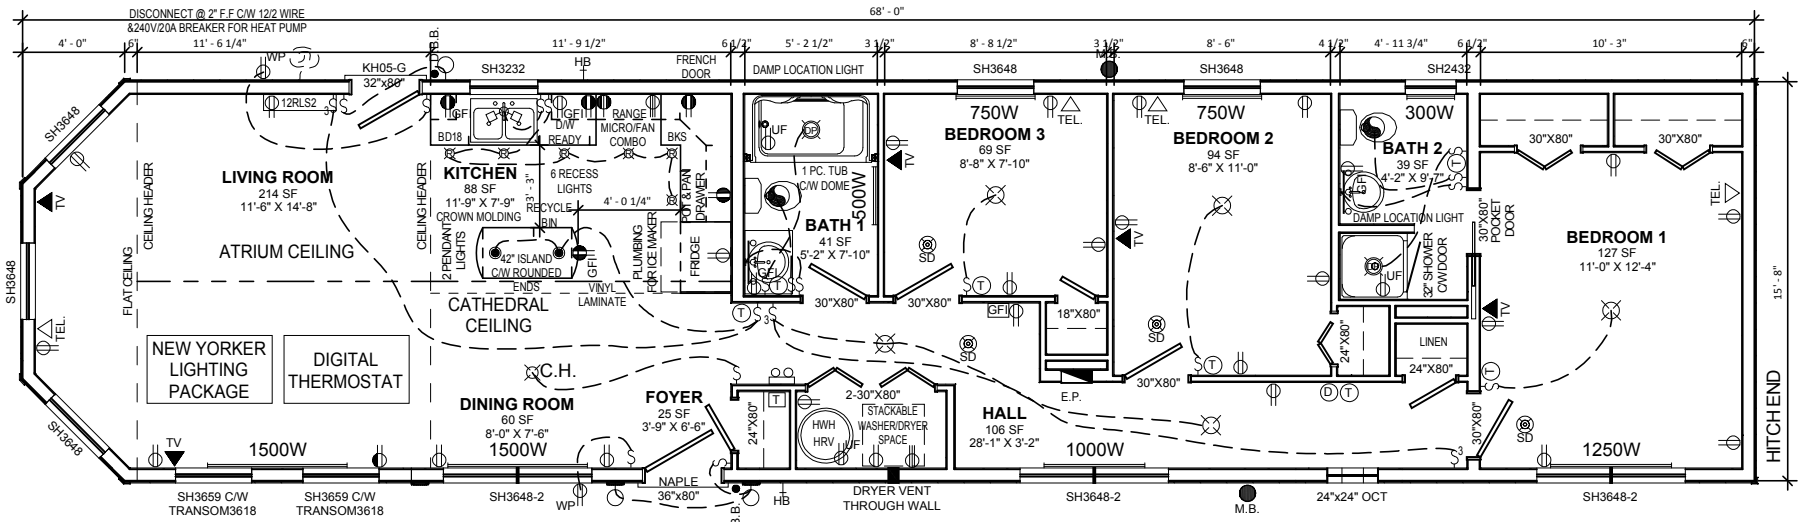


SPECIAL MEMBRANE & INCREASED NAILING PATTERN

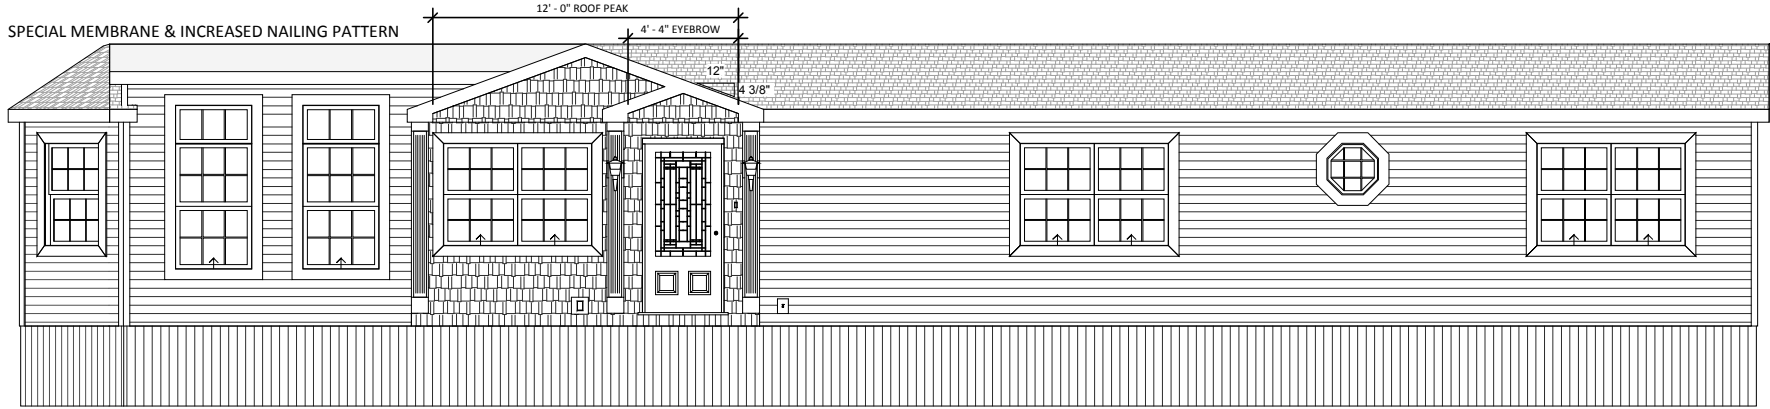

DRAWN BY: C. SAULNIER
 DATE: NOVEMBER 13, 2012
 SCALE: N.T.S.

FILE NO:
56141
 CHK BY: ENG.

CLIENT: HOMEWORX - LOT 1
 TITLE: AS BUILT DRAWING - FLOOR PLAN & FRONT ELEVATION
 15'-8" X 68'-0" MINI

