




WIDE WHITE EXTERIOR CORNERS  
ALL AROUND

VINTAGE WINDOW & DOOR TRIM

74' - 0"

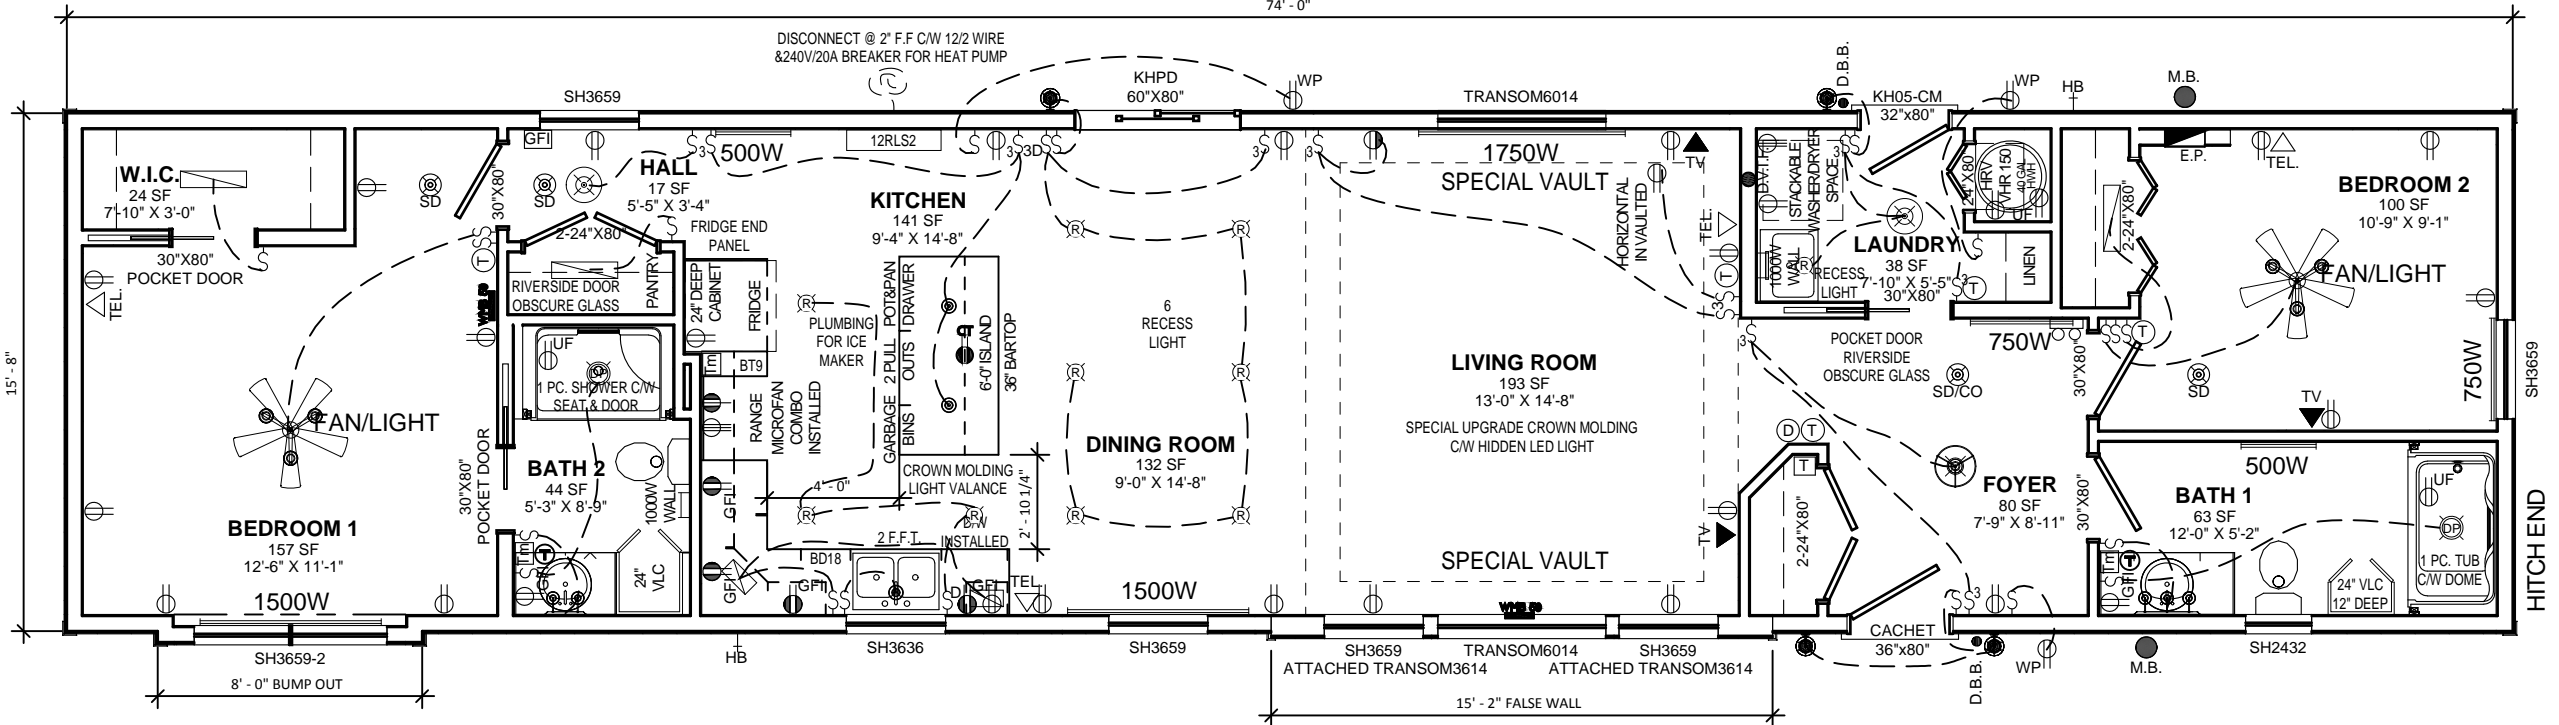

DRAWN BY: C. SAULNIER

DATE: OCTOBER 20\_2015

SCALE: N.T.S.


FILE NO:  
**56560**

CHK BY: ENG.


CLIENT: HOMEWORX - MODEL MINI HOME

TITLE: AS BUILT DRAWING - FLOOR PLAN & FRONT ELEVATION  
15'-8" X 72'-0" MINI




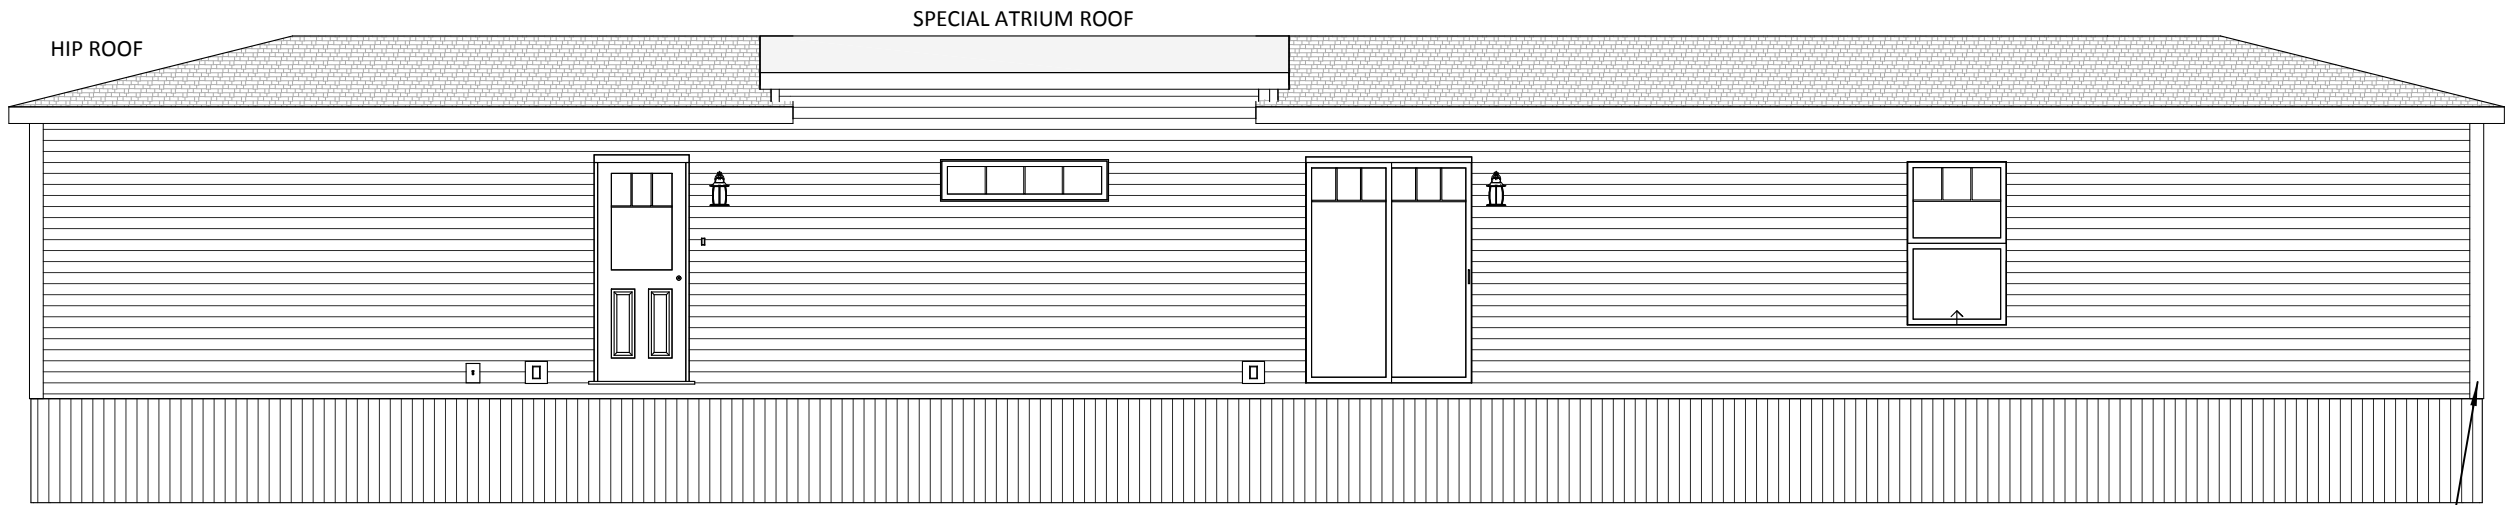

REAR ELEVATION

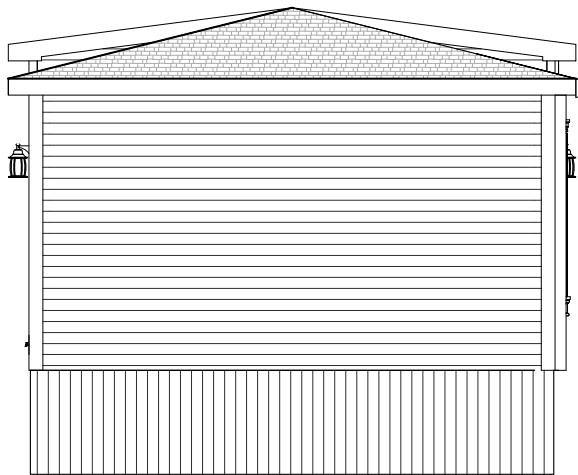

LEFT ELEVATION

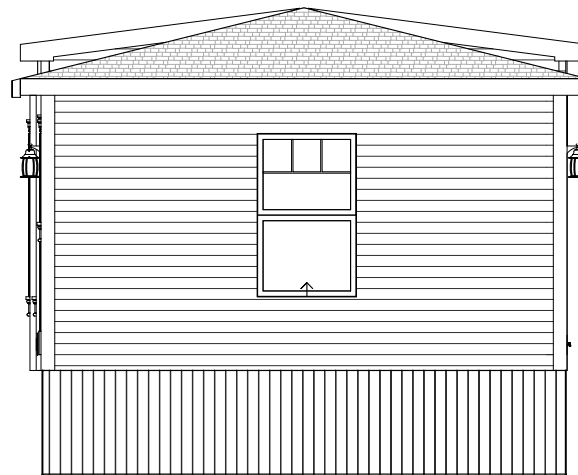

RIGHT ELEVATION

DRAWN BY: C. SAULNIER  
 DATE: OCTOBER 20\_2015  
 SCALE: N.T.S.

FILE NO:  
**56560**  
 CHK BY: ENG.

CLIENT:  
 HOMEWORX - MODEL MINI HOME  
 TITLE:  
 AS BUILT DRAWING - REAR, LEFT & RIGHT ELEVATIONS  
 15'-8" X 72'-0" MINI

